

LABOR AND MATERIALS

1 Copper Lead } Connection $\frac{3}{4}$ in. at \$

1 Curb { Cock Valve } in. at \$
 { T. S. & V. }

Service Box { Short $3\frac{1}{2} \times 4\frac{1}{2}$ } \$
 Old returned { Long $4\frac{1}{2} \times 5\frac{1}{2}$ } \$
 { Buff. or Rdway }

3/4 Ft. in. { Copper Galv. Iron } Pipe at \$
 { Cast Iron }

Nipples in. at \$

Bushings to in. at \$

Red'g Inc'g } Couplings to in. at \$

Union in. at \$

Meter in. at \$

Lead Joints at \$

Leadite Joints at \$

Hrs. Foreman at \$

Hrs. Chauffeur at \$

Hrs. Tapper at \$

Hrs. Labor at \$

Hrs. Labor at \$

Hrs. Compressor at \$

Compensation Ins. \$

Trucking \$

Builders Use of Water \$

\$

\$

\$

\$


\$

\$

St. **74**
 Pt. **64**
 Ave. No. **64**

Name of Owner McDonald

Labor and Mat'l. Report Oct 11 1939

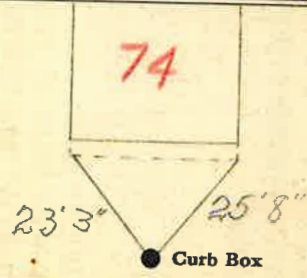

8" - 1975
 Main

Elev. of Main at tap

Gate at ● Gate at ●

TAX ID # 303.13-22-1

● Curb Box .