

LABOR AND MATERIALS

1	Copper Lead	{ Connection	3/4"		\$ 2.29
1	Curb	{ Cock Valve F.S. & V.	3/4 in.		\$ 2.70
1	Service box Old returned	{ Short 3 1/2 x 4 1/2 Long 4 1/2 x 5 1/2 Buff or Rdway			\$ 4.25
10	Ft. 3/4 in.	{ Copper G.I. C.I.	Pipe at	35	\$ 3.50
	Nipples	in. at			\$
	Bushings	to in. at			\$
	Red'g Inc'g	{ Coupl'gs	to in. at		\$
	Union	in. at			\$
	Meter	in. at			\$
	Lead Joints at				\$
	Compound Joints at				\$
	Hrs. Water Maint. Man-1 at			1.92	\$
9	Hrs. Water Maint. Man-2 at		1.02		\$ 9.18
14	Hrs. Labor	at			\$ 12.74
	Hrs. Labor	at			\$
	Hrs. Compressor at				\$
	Compensation Ins. at \$	per C.			\$ 49
	Trucking				\$ 1.00
	Pav't Patch	B.P.			\$
	Tap by	Warsinski			\$
					\$
					\$
	O'head				\$
					\$ 36.15


171-1900

(Before Paving)

St. 79
-Pl-
Ave. No. 81

Name of Owner
Mc Donald
Tony Marcantonio

Labor and Mat'l. Report Aug 3 1950

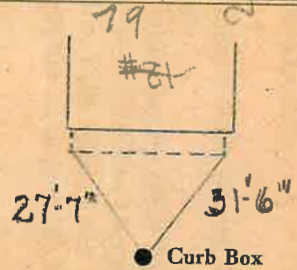

8"-1975
Main Elev. of Main at tap 6'

Gate at • Gate at

TAX ID #303.14-2-21

• Curb Box