


LABOR AND MATERIALS

1	Copper	Connection	3/4"	\$ 2.71
1	Lead	Cock	3/4 in.	\$ 3.83
1	Curb	Valve		
		F.S. & V.		
1	Service box	Short 3 1/2 x 4 1/2		\$ 4.69
	Old returned	Long 4 1/2 x 5 1/2		
		Buff or Rdway		
28	3/4 in.	Copper	Pipe at 45	\$ 12.60
		G.I.		
		G.I.		
	Nipples	in. at		\$
	Bushings	to in. at		\$
	Red'g			\$
	Inc'g	Coupl'gs to in. at		\$
	Union	in. at		\$
	Meter	in. at		\$
	Lead Joints at			\$
	Compound Joints at			\$
4	Maintenance Foreman	1.51		\$ 6.04
	Hrs. Water Maint. Man-1 at			\$
15	Hrs. Water Maint. Man-2 at	1.24		\$ 18.60
	Hrs. Garage Foreman at			\$
32	Hrs. Labor at	1.13		\$ 36.16
	Hrs. Compressor at			\$
	Compensation Ins. at \$5.686 per C			\$ 3.46
	Trucking			\$ 1.50
	Pav't Patch			\$ 26.88
	Tap by Gifford			\$
	1-27-56			\$
	O'head			\$
				\$ 116.47

McDonald St. Pl. Ave. No. 80

Name of Owner Romano.

Labor and Mat'l. Report Jan 27 1956

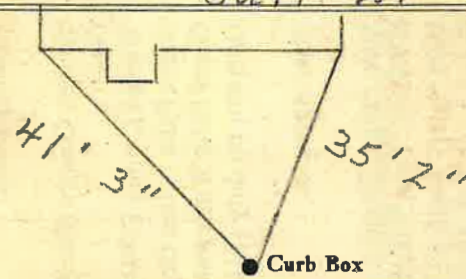

8" 1995
 X" Main Elev. of Main at tap 6'

Gate at • Gate at •

TAX ID # 303.13-22-3

• Curb Box