

LABOR AND MATERIALS

1. Copper { Connection	3/4"	\$ 2.76
1. Lead { Cock		
1. Curb { Valve	3/4" in.	\$ 3.49
	T. S. & V.	
1. Service box { Short 3/2 X 4 1/2		
Old returned { Long 4 1/2 X 5 1/2		
	Buff or Rdway	\$ 4.74
8. Ft. 3/4 in. { Copper		
	G. I.	
	C. I.	
	Pipe at	35 \$ 280
..... Nipples..... in. at		\$
..... Bushings..... to..... in. at		\$
..... Red'g {		
..... Inc'g { Coupl'gs..... to..... in. at		\$
..... Union..... in. at		\$
..... Meter..... in. at		\$
..... Lead Joints at		\$
..... Compound Joints at		\$
..... Hrs. Water Maint. Man—1 at		\$
2. Hrs. Water Maint. Man—2 at	1.24	\$ 2.48
1.8 Hrs. Labor— at	1.13	\$ 203.4
..... Hrs. Labor— at		\$
..... Hrs. Compressor at		\$
..... Compensation Ins. at \$ 2.706 per C		\$ 85
..... Trucking		\$ 1.00
..... Pav't Patch		\$ 15.68
Tap by 91159019 9-22-52		\$
..... O'head		\$
		\$ 54.14


38.46

95

St. McDonald St. Ave. No. 81

Name of Owner Albert Q. Marcantonio

Labor and Mat'l. Report Sept. 22 1952

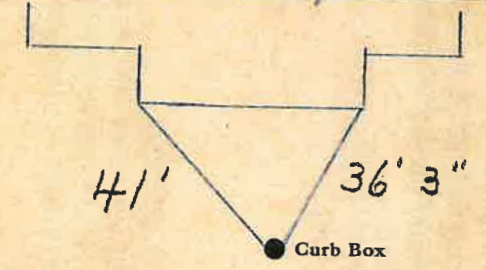

8"-1975 Main Elev. of Main at tap 5'

Gate at ● Gate at ●

TAX ID # 303.14-2-20

● Curb Box