


Labor and Materials

1	Copper	Connection	3	\$ 1.33			
1	Lead		4				
1	Curb	Cock Valve T.S.&V.	3	in	\$ 1.58			
1	Service Box	Short 3½x4½			136			
	Old returned	Long 4½x5½						
		Buff. or Rawls						
10	Ft.	¾ in.		Pipe at	\$ 95			
	Nipples	in. at			\$			
	Bushings	to in. at			\$			
	Red'g	Couplings	to in. at		\$			
	Inc'g							
	Union	in. at			\$			
	Meter	in. at			\$			
	Lbs. Br. Stone	at			\$			
	Lbs. Sand	at			\$			
	Bags Cement	at			\$			
	Paving Brick	Mack Red Asphalt	at		\$			
	Lead Joints					at		\$
	Leadite Joints					at		\$
3	Hrs. Foreman				\$ 1.88			
8	Hrs. Common Labor	Tapper			\$ 4.00			
8	Hrs. Common Labor				\$ 3.60			
	Hrs. Mason	at			\$			
	Hrs. Masons Helper	at			\$			
	Hrs. Compressor	at			\$			
	Compensation Ins				\$ 29			
	Trucking				\$ 1.50			
	Builders Use of Water	Patch			\$ 5.00			
Total \$					20 99			

33-13 89
 Labor and Material Report *April 21 1933*

77 McDonald St

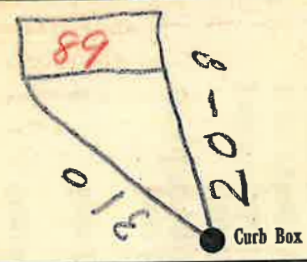

4 8"-19" N
 Main Elev. of Main at tap *5*

Gate at ● TAX ID # 303.14-2-17 ● Gate at

● Curb Box

old Tap disconnected

[Signature]

m