

LABOR AND MATERIALS

Copper } Connection _____ \$ _____	
Lead } _____ \$ _____	
Curb } Cock _____ in. _____ \$ _____	
} Valve _____	
} T. S. & V. _____	
Service box { Short 3½ x 4½ _____ \$ _____	
Old returned { Long 4½ x 5½ _____	
} Buff or Rdway _____	
24 Ft. ² / ₁ in. { Copper } Pipe at _____ \$ _____	
} G.I. _____	
} C.I. _____	
Nipples _____ in. at _____ \$ _____	
Bushings _____ to _____ in. at _____ \$ _____	
Red'g } Coupl'gs _____ to _____ in. at _____ \$ _____	
Inc'g } _____	
Union _____ in. at _____ \$ _____	
Meter _____ in. at _____ \$ _____	
Lead Joints at _____ \$ _____	
Compound Joints at _____ \$ _____	
Maintenance Foreman _____ \$ _____	
Hrs. Water Maint. Man—1 at _____ \$ _____	
Hrs. Water Maint. Man—2 at _____ \$ _____	
Hrs. Garage Foreman _____ at _____ \$ _____	
Hrs. Labor _____ at _____ \$ _____	
Hrs. Compressor at _____ \$ _____	
Compensation Ins. at \$ _____ per C _____ \$ _____	
Trucking _____ \$ _____	
Pav't Patch _____ \$ _____	
_____ \$ _____	
_____ \$ _____	
_____ \$ _____	
O'head _____ \$ _____	
_____ \$ _____	

St. _____
 Pl. _____
 Ave. No. 90


90 McDONALD

Name of Owner

TERRY MARCANTONIO

Labor and Mat'l. Report

JUNE 2 1980

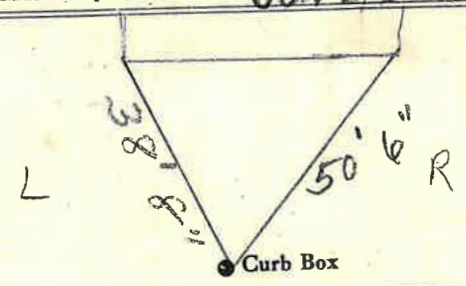

8 Main

Elev. of Main at tap 5'

Gate at •

• Gate at

TAX ID # 303.13-22-6

• Curb Box

L.V.