

LABOR AND MATERIALS

1	Copper	Lead	Connection	3/4"	\$ 2.29	
			Cock Valve	Used Same		
			F.S. & V.	1 in.	\$	
1	Service box	Short	3 1/2 x 4 1/2			
	Old returned	Long	4 1/2 x 5 1/2		\$ 4.25	
		Buff or Rdway				
24	Ft. 3/4 in.	Copper	Pipe at	35	\$ 8.40	
		G.I.				
	Nipples		in. at		\$	
1	Bushings	1"	to 3/4 in. at		\$	
	Red'g Inc'g	Coupl'gs	to in. at		\$	
1	Union	3/4"	Cu to Fe Adapter		\$	
	Meter		in. at		\$	
	Lead Joints at				\$	
	Compound Joints at				\$	
	Hrs. Water Maint. Man-1	at			\$	
11	Hrs. Water Maint. Man-2	at	1.02		\$ 11.22	
17	Hrs. Labor	at	91		\$ 15.47	
	Hrs. Labor	at			\$	
	Hrs. Compressor at				\$	
	Compensation Ins. at \$	per C.			\$ 59	
	Trucking				\$ 1.1	
	Pav't Patch	B.P.			\$	
	Tap by Wa'sinski				\$	
	O'head				\$	
					\$ 43.72	

17-1950

(Before Taping)

Mc Donald

St.
Pl:


Ave. No. 96

Name of Owner

Cuthbert Crannell

Labor and Mat'l. Report

Aug 2 1950

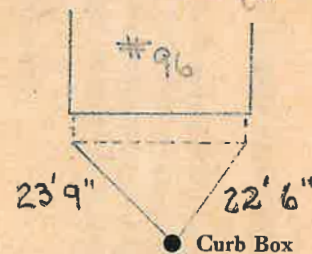

8"-1975

8" Main

Elev. of
Main at tap 6

Gate at ●

● Gate at

TAX ID # 303.13-22-7

● Curb Box