

LABOR AND MATERIALS

Copper	} Connection	_____	\$ _____
Lead			
Curb	} Cock Valve T. S. & V.	_____ in.	\$ _____
Service box		} Short 3½ x 4½ Long 4½ x 5½	
Old returned			
10 Ft. ¾ in.	} Copper G.I. G.I.	Pipe at	\$ _____
Nipples		in. at	\$ _____
Bushings		to _____ in. at	\$ _____
Red'g Inc'g	} Coupl'gs	to _____ in. at	\$ _____
Union		in. at	\$ _____
Meter	in. at	\$ _____	
_____			\$ _____
Compound Joints	at		\$ _____
Maintenance Foreman			\$ _____
Hrs. Water Maint. Man—1	at		\$ _____
Hrs. Water Maint. Man—2	at		\$ _____
Hrs. Garage Foreman	at		\$ _____
Hrs. Labor—	at		\$ _____
Hrs. Compressor	at		\$ _____
_____			\$ _____
Trucking			\$ _____
Pav't Patch			\$ _____
_____			\$ _____
_____			\$ _____
_____			\$ _____
_____			\$ _____


Mc Donald

St. Pl. Ave. No. 97

Name of Owner

Labor and Mat'l. Report

1988

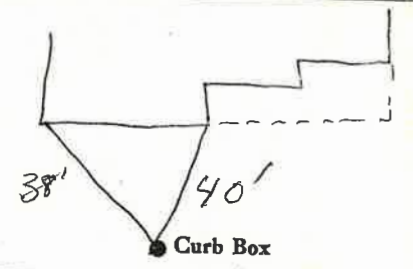

Main Elev. of Main at tap
 Gate at • Gate at

TAX ID # 303.14-2-13.1

• Curb Box