

LABOR AND MATERIALS


1	Copper Lead	Connection	3/4	\$	179
1	Curb	Clock Valve T.S. & V.	3/4 in.	\$	261
1	Service box Old returned	Short 3 3/4 X 4 3/4 Long 4 3/4 X 5 3/4 Buff or Rdway		\$	1.82
12 14	Ft.	3/4 in.	Copper Galv. Iron Cast Iron	Pipe at	23 276
	Nipples	in. at		\$	
	Bushings	to in. at		\$	
1	Red'g Inc'g	Couplings	3/4 to 3/4		Cap. to Cop.
	Union	in. at		\$	
	Meter	in. at		\$	
	Lead Joints at			\$	
	Compound Joints at			\$	
2	Hrs. Foreman at	W.W.M.	92 1/2	\$	1.85
4	Hrs. Chauffeur at		82 1/2	\$	3.30
	Hrs. Tapper at			\$	
6	Hrs. Labor at		71 1/2	\$	4.29
	Hrs. Labor at			\$	
	Hrs. Compressor at			\$	
	Compensation Ins.			\$	26
	Trucking			\$	1.00
	Builders Use of Water			\$	5.00
	Tap by Warsaw			\$	
					\$24.68

100 J 46

St. 13
Pl. McDonald
Ave. No. 9

Name of Owner
Casey

Labor and Mat'l. Report *Oct 15* 19*46*

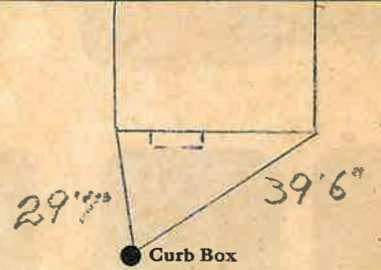

8:1958
Main
Elev. of Main at tap *5 1/2'*

Gate at Gate at

TAX ID # 303.18-12-2

● Curb Box