


Labor and Materials

1	Lead Connection	2.94	\$
	Curb Cock	2.94	\$
	Service Box		\$
	Old returned		\$
	Short 3 1/2 x 4 1/2		\$
	Long 4 1/2 x 5 1/2		\$
	Buffalo		\$
2	7 Ft. 3/4 in. G. I. Pipe at	10.37	\$
	Nipples		\$
	in. at		\$
	Bushings		\$
	to in. at		\$
	Red'g Coup		\$
	to in. at		\$
	Inc'g Coup		\$
	to in. at		\$
	Union		\$
	in. at		\$
	Meter		\$
	in. at		\$
	Cu. Yds. Br. Stone at		\$
	Cu. Yds. Sand at		\$
	Bags Cement at		\$
	Paving Brick		\$
	{ Mack		\$
	{ Red		\$
	{ Asphalt }		\$
2	Hrs. Foreman at		\$
2.79	Hrs. Common Labor at		\$
	Hrs. Mason at		\$
	Hrs.		\$
	at		\$
	Hrs.		\$
	at		\$
No	Builders' Use of Water		\$
	at		\$
	Truck		\$
	at		\$
	at		\$
	at		\$
	Total	11.47	\$

12 2 14 Mission St.

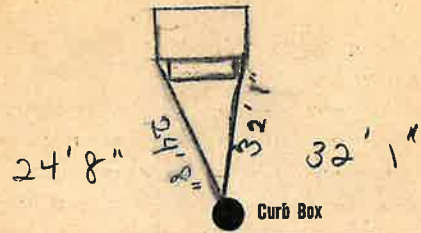

Main Elev. of Main at tap

Gate at ● ● Gate at

