


**Labor and Materials**

Lead Connection .....	no	\$
Curb Cock .....	12P	\$
Service Box { Short 3½ x 4½ Old returned { Long 4½ x 5½ Buffalo	Made	\$
Ft. .... in. G. I. Pipe at .....		\$
Nipples .... in. at .....		\$
Bushings .... to .... in. at .....		\$
Red'g Coup. .... to .... in. at .....		\$
Inc'g Coup. .... to .... in. at .....		\$
Union .... in. at .....		\$
Meter .... in. at .....		\$
Cu. Yds. Br. Stone at .....		\$
Cu. Yds. Sand at .....		\$
Bags Cement at .....		\$
Paving Brick { Mack Red Asphalt } at .....		\$
Hrs. Foreman at .....		\$
Hrs. Common Labor at .....		\$
Hrs. Mason at .....		\$
Hrs. .... at .....		\$
Hrs. .... at .....		\$
Builders' Use of Water .....		\$
..... at .....		\$
..... at .....		\$
..... at .....		\$
..... at .....		\$
Total .....		\$

**Labor and Material Report**

15 Mission St.

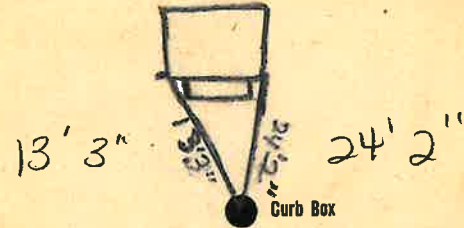

\_\_\_\_\_ Main Elev. of  
Main at tap

Gate at ● ● Gate at




Tax ID# 309.27-6-46.1

### Labor and Materials

1	Lead Connection	3/4"	\$.
1	Curb Cock		\$.
1	Service Box	{ Short 31 x 41 Long 41 x 51 Buffalo	\$.
16	Ft. 1"	in. G. I. Pipe at	\$.
	Nipples	in. at	\$.
1	Bushings	1/2" to 1/2" in. at	\$.
	Red'g Coup	to in. at	\$.
	Inc'g Coup	to in. at	\$.
	Union	in. at	\$.
	Meter	in. at	\$.
	Cu. Yds. Br Stone	at	\$.
	Cu. Yds. Sand	at	\$.
	Bags Cement	at	\$.
	Paving Brjck	{ Mack Red Asphalt } at	\$.
3	Hrs. Foreman	at	\$.
12	Hrs. Common Labor	at	\$.
	Hrs. Mason	at	\$.
	Hrs.	at	\$.
	Hrs.	at	\$.
70	Builders' Use of Water	at	\$.
	Track	150	at \$.
		at	\$.
		at	\$.
	Total	\$.	14.45

*3/4" tap at 15' Main*

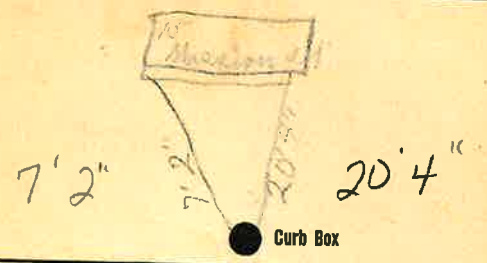

*15" Main* Elev. of Main at tap *51'*

Gate at ● Gate at ●

● Curb Box

Tax ID<sup>no</sup> 309.27-6-46.1