


Labor and Materials

Lead Connection <i>3/4</i>	\$
Curb Cock <i>3/4</i>	\$
Service Box (Short $3\frac{1}{2}$ x 4)	\$
Old returned (Long $4\frac{1}{2}$ x 5)	\$
<i>19</i> Ft. <i>3/4</i> in. G. I. Pipe at <i>cap</i>	\$
Nipples..... in. at.....	\$
Bushings..... to..... in. at.....	\$
Red'g Coup..... to..... in. at.....	\$
Inc'g Coup..... to..... in. at.....	\$
Union..... in. at.....	\$
Meter..... in. at.....	\$
Cu. Yds. Br. Stone at.....	\$
Cu. Yds. Sand at.....	\$
Bags Cement at.....	\$
Paving Brick { Mack Red Asphalt } at.....	\$
<i>33</i> Hrs. Foreman at.....	\$
<i>14 1/2</i> Hrs. Common Labor at.....	\$
Hrs. Mason at.....	\$
Hrs..... at.....	\$
Hrs..... at.....	\$
<i>No</i> Builders' Use of Water.....	\$
..... at.....	\$
..... at.....	\$
<i>Truck</i> at.....	\$ 1.00
..... at.....	\$
Total	\$	17.80

Labor and Material Report

17 Mission St.

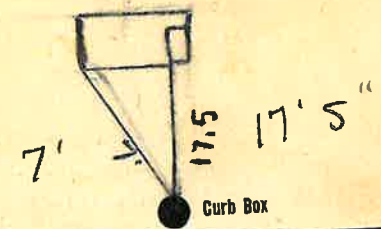

Main Elev. of Main at tap
 Gate at ● Gate at ●

12 1/2" Curb Box
 Curb inside of walk.