


Labor and Materials

Copper } Connection.....	3/4"	\$ 2.70
Lead }	3/4"	
Curb } Cock Valve }	in. 3/4"	\$ 2.39
T-S & V. }		
Service Box } Short 3/4" x 4 1/2" }		\$ 1.45
Old returned } Long 1 1/2" x 5 1/2" }		
	Buff. or Rdway }	
2.6 Ft. in. } Copper } Pipe at.....	3/4"	\$ 7.02
	Cast Iron }	
Nipples.....	in. at.....	\$
Bushings.....	to..... in. at.....	\$
Red'g } Couplings.....	to..... in. at.....	\$
Inc'g }		
Union.....	in. at.....	\$
Meter.....	in. at.....	\$
Lbs. Br. Stone at.....		\$
Lbs. Sand at.....		\$
Bags Cement at.....		\$
Paving Brick } Mack } at.....		\$
	Red }	
	Asphalt }	
Lead Joints at.....		\$
Leadite Joints at.....		\$
3 Hrs. Foreman at.....		\$ 1.88
1.8 Hrs. Common Labor at.....		\$ 2.10
Hrs. Common Labor at.....		\$
Hrs. Mason at.....		\$
Hrs. Mason's Helper at.....		\$
Hrs. Compressor at.....		\$
Compensation Ins.....		\$.31
Trucking.....		\$ 1.00
Builders' Use of Water Patch.....		\$ 5.00
Total \$		29.85

30-155
 Labor and Material Report *Cont* 28 1930

20 Mission St

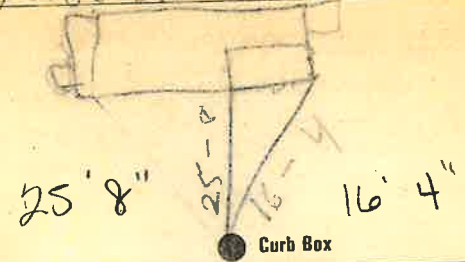

Front of Main

4 Main Elev of Main at tap 5
 Gate at ● Gate at ●

● Curb Box

Ad Tap
Discontinued