


Labor and Materials

1	Lead Connection.....	\$ 3.25
	Curb Cock.....	\$.90
V	Service Box { Short 3½ x 4½ Old returned } Long 4½ x 5½ Buffalo	\$ 1.48
7	¾ in. G. I. Pipe at.....	\$ 1.54
	Nipples..... in. at.....	\$.
	Bushings..... to..... in. at.....	\$.
	Red'g Coup..... to..... in. at.....	\$.
	Inc'g Coup..... to..... in. at.....	\$.
	Union..... in. at.....	\$.
	Meter..... in. at.....	\$.
	Cu. Yds. Br. Stone at.....	\$.
	Cu. Yds. Sand at.....	\$.
	Bags Cement at.....	\$.
	Paving Brick { Mack Red Asphalt } at.....	\$.
2	Hrs. Foreman at.....	\$ 1.25
8.4	Hrs. Common Labor at.....	\$ 3.35
	Hrs. Mason at.....	\$.
	Hrs..... at.....	\$.
	Hrs..... at.....	\$.
No	Builders' Use of Water.....	\$.
	at.....	\$.
	TRUCK.....	\$ 1.00
	at.....	\$.
	at.....	\$.
	at.....	\$.
	Total	\$ 12.86

Vacant lot H. Mission St

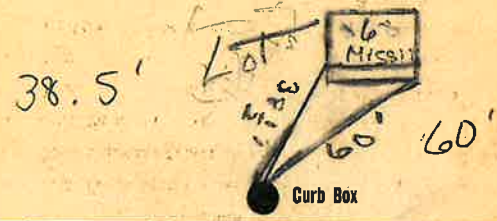

Main	Elev. of Main at tap
Gate at ●	● Gate at

