


Labor and Materials

1	Lead Connection	3/4	\$ 3.20
1	Curb Cock	3/4	\$ 1.00
1	Service Box	{ Short 31 x 41	
	Old returned	{ Long 41 x 51	
		{ Buffalo	
15	Ft. 1/2 in. G. I. Pipe at	cap	\$ 3.30
	Nipples	in. at	\$
	Bushings	to in. at	\$
	Red'g Coup	to in. at	\$
	Inc'g Coup	to in. at	\$
	Union	in. at	\$
	Meter	in. at	\$
	Cu. Yds. Br. Stone at		\$
	Cu. Yds. Sand at		\$
	Bags Cement at		\$
	Paving Brick	{ Mack Red Asphalt } at	\$
3 3/4	Hrs. Foreman at		\$ 2.30
14 1/2	Hrs. Common Labor at		\$ 5.90
	Hrs. Mason at		\$
	Hrs.	at	\$
	Hrs.	at	\$
No	Builders' Use of Water		\$
		at	\$
	Trock	at	\$ 1.00
	Comp. Gas	at	\$.22
		at	\$
	Total		\$ 16.99

Labor and Material Report

7 Mission St.

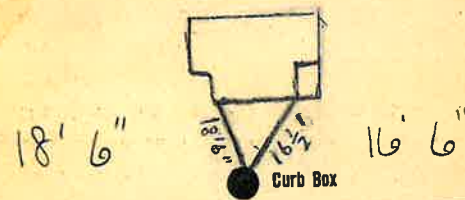

Main Elev. of
Main at tap

Gate at ● ● Gate at



Tax ID# 309,35-1-12