

LABOR AND MATERIALS

1	Copper	Connection	\$
	Lead		
1	Curb	Cock Valve } $\frac{3}{4}$ " T.S. & V. } in.	\$
1	Service box	Short $3\frac{1}{2}$ x $4\frac{1}{2}$ Long $4\frac{1}{2}$ x $5\frac{1}{2}$ Buff or Rdway	\$
	Old returned		
6	Ft. $\frac{3}{4}$ in.	Copper } C.I. } Pipe at C.I. }	\$
	Nipples	in. at	\$
	Bushings	to in. at	\$
	Red'g } Inc'g }	Coupl'gs to in. at	\$
	Union	in. at	\$
	Meter	in. at	\$
	Lead Joints	at	\$
	Compound Joints	at	\$
	Maintenance Foreman		\$
	Hrs. Water Maint. Man-1	at	\$
	Hrs. Water Maint. Man-2	at	\$
	Hrs. Garage Foreman	at	\$
	Hrs. Labor	at	\$
	Hrs. Compressor	at	\$
	Compensation Ins. at \$	per C	\$
	Trucking		\$
	Pav't Patch		\$
			\$
	Tap	Aug 8, 1979	\$
			\$
	O'head		\$
			\$


MISSION

St. 9
-Pl-
Ave. No.

Name of Owner

Leonard E. Maynard

Labor and Mat'l. Report Aug 8, 1979

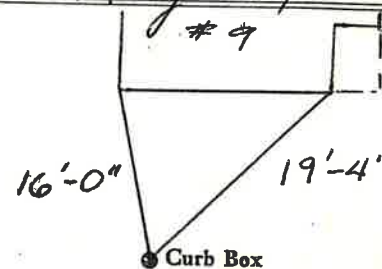

10" Main

Elev. of Main at tap 5'

Gate at •

• Gate at

• Curb Box

Tax ID # 309.35-1-11