

LABOR AND MATERIALS


1 Copper } Connection 1" \$
 1 Lead }
 1 Curb } Cock } 1 in. \$
 } Valve }
 } T.S. & V. }
 1 Service box { Short 3 1/2 x 4 1/2 }
 Old returned { Long 4 1/2 x 5 1/2 } \$
 } Buff or Rdway }
 20 Ft. 1 in. { Copper } Pipe at \$
 } G.I. }
 } C.I. }
 Nipples in. at \$
 Bushings to in. at \$
 Red'g } Coupl'gs to in. at \$
 Inc'g }
 Union in. at \$
 Meter in. at \$
 Lead Joints at \$
 Compound Joints at \$
 Maintenance Foreman \$
 Hrs. Water Maint. Man-1 at \$
 Hrs. Water Maint. Man-2 at \$
 Hrs. Garage Foreman at \$
 Hrs. Labor at \$
 Hrs. Compressor at \$
 Compensation Ins. at \$ per C \$
 Trucking \$
 Pav't Patch \$
 Tap by Gissard, \$
 Miller Co. \$
 5-16-57 \$
 O'head \$
 \$
 \$

Measurements for V
 Shut off on 1" Copper
 Main on
 Mohawk
 St. _____
 Pl. _____
 Ave. No. _____

Name of Owner _____

Labor and Mat'l. Report

May 16 19 57

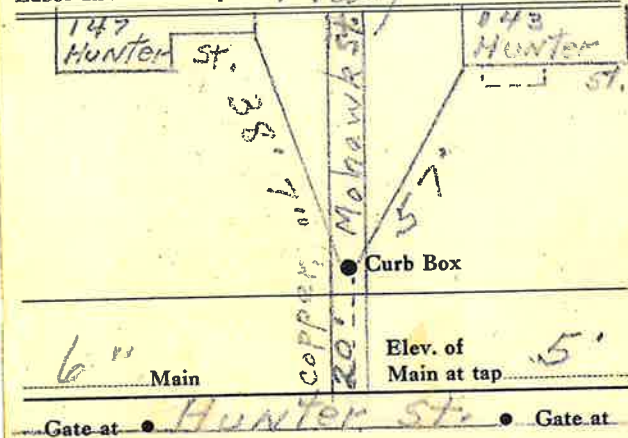

● Curb Box

Tap on Hunter St.
 End of main on
 Mohawk St. 188' from
 1" shut off.