


LABOR AND MATERIALS

1	Copper Lead	Connection	1" x 3/4"	\$
2	Curb	Cock Valve T.S. & V.	Brass Tee 3/4 in.	\$
1	Service box - Old returned	Short 3 1/2 x 4 1/2 Long 4 1/2 x 5 1/2 Buff or Rdway		\$
14	3/4 in. Ft.	Copper G.I. C.I.	Pipe at	\$
1	Nipples	3/4 in. at	3" x Brass	\$
	Bushings	to in. at		\$
	Red'g Inc'g	Coupl'gs to in. at		\$
	Union	in. at		\$
	Meter	in. at		\$
	Lead Joints at			\$
	Compound Joints at			\$
	Maintenance Foreman			\$
	Hrs. Water Maint. Man-1 at			\$
	Hrs. Water Maint. Man-2 at			\$
	Hrs. Garage Foreman at			\$
	Hrs. Labor at			\$
	Hrs. Compressor at			\$
	Compensation Ins. at \$	per C		\$
	Trucking			\$
	Pav't Patch			\$
	Tap by Gifford			\$
	Miller & Co 5-24-57			\$
	O'head			\$

St. ✓
Ma hawk
 Ave. No. 21

Name of Owner
Duell

Labor and Mat'l. Report May 24 1957

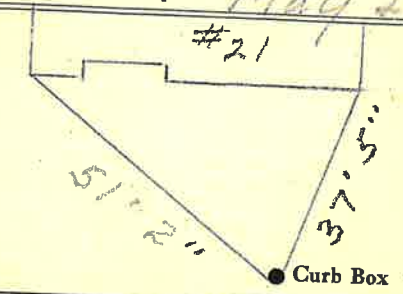

Copper
1" Main Elev. of Main at tap 4'

Gate at ● Gate at ●
14' to main

● Curb Box

Tax ID# 303.13-13-9