


LABOR AND MATERIALS

- 1 Copper Lead Connection $1'' \times \frac{3}{4}''$ Brass Tee \$
- 2 Curb Cocks $\frac{3}{4}''$ iron to iron main. \$
- Valve T. S. & V. $\frac{1}{2}''$ in. at \$
- 1 Service box Short $3\frac{1}{2}'' \times 4\frac{1}{2}''$ 0-1 seal. \$
- Old returned Long $4\frac{1}{2}'' \times 5\frac{1}{2}''$ at \$
- Buff or Rdway at \$
- 30 Ft. $\frac{3}{4}''$ in. Copper Pipe at \$
- G.I. } Pipe at \$
- G.I. } Pipe at \$
- 1 Nipples $1''$ in. at Brass 6" L \$
- 1 Bushings $\frac{3}{4}''$ to Adapter \$
- Red'g Inc'g Coupl'gs to in. at \$
- 1 Nipple $\frac{3}{4}'' \times 3''$ in. at \$
- 1 Union in. at \$
- Meter in. at Brass \$
- 1 Lead Joints at $1''$ Brass Plug \$
- Compound Joints at \$
- Maintenance Foreman \$
- Hrs. Water Maint. Man-1 at \$
- Hrs. Water Maint. Man-2 at \$
- Hrs. Garage Foreman at \$
- Hrs. Labor at \$
- Hrs. Compressor at \$
- Compensation Ins. at \$ per C. \$
- Trucking \$
- Pay't Patch \$
- PUT IN AT MAIN \$
- by Gifford Miller \$
- J.C.O. 5-24-57 \$
- O'head \$

FOR LOT ACROSS
 F1-0177 #21
 St. ✓
 Mohawk Pl-
 Ave. No. 22

Name of Owner
 Andrew DeSignore.
 30' - $\frac{3}{4}''$ K. Cop. installed 6-26-69
 Labor and Mat'l. Report May 24 19 57

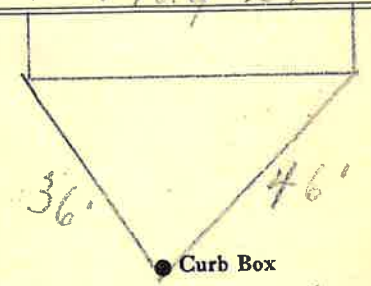

1" Copper Main Elev. of Main at tap 4'
 Gate at • Gate at •
 30' to main TAX ID # 303.13-12-1

• Curb Box
 This material on
 End of 1" Copper
 Main on Mohawk St.
 188' from 1" shut
 off - 5-24-57