


Labor and Materials

| | | | | |
|----------|--------------------------|-----------------------------|-----------|----------|
| 1 | Copper | } Connection 2' | | |
| | Lead | | | \$ 72.77 |
| 1 | Curb | } Cock Valve T.S. & V. } | } 2' in. | \$ 14.55 |
| 1 | Service Box Old returned | | | |
| 4 | Ft. 2 | Copper Galv. Iron Cast Iron | Pipe at | \$ 2.00 |
| | Nipples | in. at | | \$ |
| | Bushings | to in. at | | \$ |
| | Red'g Inc'g | Couplings | to in. at | \$ |
| | Union | in. at | | \$ |
| | Meter | in. at | | \$ |
| | Lbs. Br. Stone | at | | \$ |
| | Lbs. Sand | at | | \$ |
| | Bags Cement | at | | \$ |
| | Paving Brick | } Mack Red Asphalt } | at | \$ |
| | Lead Joints | | at | \$ |
| | Leadite Joints | | at | \$ |
| 32 | Hrs. Foreman | at | | \$ 20.00 |
| 17 | Hrs. Common Labor | at | | \$ 8.55 |
| | Hrs. Common Labor | at | | \$ |
| | Hrs. Mason | at | | \$ |
| | Hrs. Mason's Helper | at | | \$ |
| 5 | Hrs. Compressor | at | | \$ 7.50 |
| | Compensation Ins. | | | \$ 87 |
| | Trucking | | | \$ 1.00 |
| | Builders' Use of Water | Patch | | \$ 23.00 |
| Total \$ | | | | 105.24 |

May 21
 Dig 2' top
 Measure from 1' below

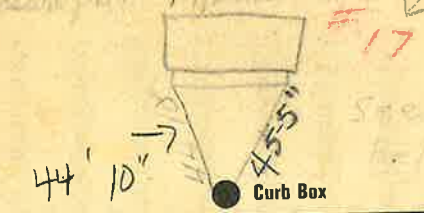

24" Main Elev of Main at tap
 Gate at ● Gate at ●

● Curb Box

New top For
Niagara Mohawk
Power Co.

