


Labor and Materials

1	Copper } Connection $3/4$	\$ 3 20
	Lead	
1	Curb { Cock Valve } $3/4$ in.	\$ 1 00
	{ T-S. & V. }	
1	Service Box { Short $3\frac{1}{2}$ x $4\frac{1}{2}$ }	\$ 1 40
	Old returned { Long $4\frac{1}{2}$ x $5\frac{1}{2}$ }	
	{ Buff. or Rdway }	
1	Ft. $3/4$ in. { Copper } Pipe at	\$ 46 2
	{ Galv. Iron }	
	{ Cast Iron }	
	Nipples.....in. at.....	\$
1	Bushings $3/4$ to $1/2$ in. at.....	\$ 08
	Red'g } Couplings.....to.....in. at.....	\$
	Inc'g }	
	Union.....in. at.....	\$
	Meter.....in. at.....	\$
	Lbs. Br. Stone at.....	\$
	Lbs. Sand at.....	\$
	Bags Cement at.....	\$
	Paving Brick { Mack } at.....	\$
	{ Red }	
	{ Asphalt }	
	Lead Joints at.....	\$
	Leadite Joints at.....	\$
3	Hrs. Foreman at..... 62.5	\$ 18 8
3	Hrs. Common Labor at..... 50	\$ 15 0
19	Hrs. Common Labor at..... 70.2	\$ 77 2
	Hrs. Mason at.....	\$
	Hrs. Mason's Helper at.....	\$
	Hrs. Compressor at.....	\$
	Compensation Ins..... 30	\$
	Trucking..... 1.00	\$
	Builders' Use of Water.....	\$
Total		\$ 227 0

23

Labor and Material Report Aug 30 1926

344 25 ft of 7" diam at

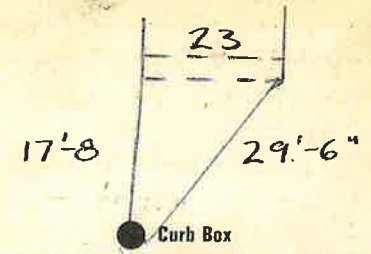

Main Elev. of Main at tap 44

Gate at ● Gate at ●

● Curb Box

Hess. Clements

Labor and Materials

1	Copper } Connection.....	\$.....
	Lead }	\$.....
1	Curb { Cock } 3/4 in.....	\$.....
	{ Valve }	\$.....
	{ T. S. & V. }	\$.....
1	Service Box { Short 3 1/2 x 4 1/2 }	\$.....
	Old returned { Long 4 1/2 x 5 1/2 }	\$.....
	{ Buff. or Rdway }	\$.....
20	Ft. 3/4 in. { Copper } Pipe at.....	\$.....
	{ Galv. Iron }	\$.....
	{ Cast Iron }	\$.....
	Nipples..... in. at.....	\$.....
	Bushings..... to..... in. at.....	\$.....
1	Red'g } Couplings 3/4 to..... in. at.....	\$.....
	Inc'g }	\$.....
	Union..... in. at.....	\$.....
	Meter..... in. at.....	\$.....
	Lbs. Br. Stone at.....	\$.....
	Lbs. Sand at.....	\$.....
	Bags Cement at.....	\$.....
	Paving Brick { Mack } at.....	\$.....
	{ Red }	\$.....
	{ Asphalt }	\$.....
	Lead Joints at.....	\$.....
	Leadite Joints at.....	\$.....
	Hrs. Foreman at.....	\$.....
	Hrs. Common Labor at.....	\$.....
	Hrs. Common Labor at.....	\$.....
	Hrs. Mason at.....	\$.....
	Hrs. Mason's Helper at.....	\$.....
	Hrs. Compressor at.....	\$.....
	Compensation Ins.....	\$.....
	Trucking.....	\$.....
	Builders' Use of Water.....	\$.....
	Total \$.....	

Labor and Material Report

3 1/2 ft at Hoboken?

23?



2'0"
2'6" 1/4"
Curb Box

Main Elev. of Main at top 8 1/2
Gate at ● Gate at ●

● Curb Box