


**Labor and Materials**

1	Copper } Connection <sup>3/4"</sup>	\$ 3.20
	Lead	
1	Curb } Cock Valve } <sup>3/4"</sup> in.	\$ 1.00
	T.S. & V.	
1	Service Box } Short 3' x 4' }	\$ 1.40
	Old returned } Long 4' x 5' }	
		Buff. or Rdway }
19	Ft. <sup>3/4"</sup> in. } Copper } Pipe at.	\$ 4.18
		Galv. Iron }
		Cast Iron }
	Nipples.....in. at.	\$
1	Bushings <sup>3/4"</sup> to <sup>1/2"</sup> in. at.	\$ .08
	Red'g } Couplings.....to.....in. at.	\$
	Inc'g }	
	Union.....in. at.	\$
	Meter.....in. at.	\$
	Lbs. Br. Stone at.	\$
	Lbs. Sand at.	\$
	Bags Cement at.	\$
	Paving Brick } Mack } at.	\$
		Red }
		Asphalt }
	Lead Joints at.	\$
	Leadite Joints at.	\$
3	Hrs. Foreman at..... <sup>6.25</sup>	\$ 1.88
7	Hrs. Common Labor at..... <sup>5.0</sup>	\$ 3.50
28	Hrs. Common Labor at..... <sup>4.8</sup>	\$ 11.38
	Hrs. Mason at.	\$
	Hrs. Mason's Helper at.	\$
	Hrs. Compressor at.	\$
	Compensation Ins.....	\$ .45
	Trucking.....	\$ 1.00
	Builders' Use of Water.....	\$
Total		\$ 28.07

*32' 0" at T. S. & V.*

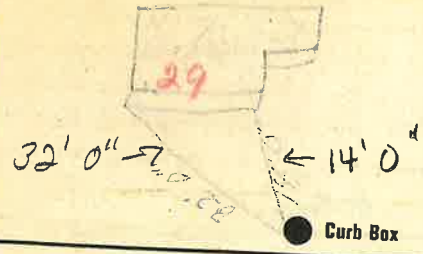

Main Elev. of Main at tap

Gate at ● ● Gate at

● Curb Box

*Samuel Cohen*

Tax ID # 309.36-2-9

(Hospital)