


Labor and Materials

1	Copper Lead	Connection $3/4"$	\$ 3.20
1	Curb	Cock Valve T. S. & V. } $3/4"$ in.	\$ 1.00
1	Service Box	Short $3\frac{1}{2} \times 4\frac{1}{2}$ } Old returned } Long $4\frac{1}{2} \times 5\frac{1}{2}$ } Buff. or Rdway }	\$ 1.20
17	Ft.	$3/4"$ in. } Copper Galv. Iron } Pipe at. Cast Iron }	\$ 3.74
	Nipples	in. at.	\$
1	Bushings	$3/4"$ to $1/2"$ in. at.	\$.08
	Red'g Inc'g } Couplings	to in. at.	\$
	Union	in. at.	\$
	Meter	in. at.	\$
	Lbs. Br. Stone	at.	\$
	Lbs. Sand	at.	\$
	Bags Cement	at.	\$
	Paving Brick	{ Mack Red Asphalt } at.	\$
	Lead Joints	at.	\$
	Leadite Joints	at.	\$
3	Hrs. Foreman	at. 62.5	\$ 1.88
2	Hrs. Common Labor	at. 50	\$ 1.00
14	Hrs. Common Labor	at. $40 \frac{5}{8}$	\$ 1.39
	Hrs. Mason	at.	\$
	Hrs. Mason's Helper	at.	\$
	Hrs. Compressor	at.	\$
	Compensation Ins.		\$ 2.4
	Trucking		\$ 1.00
	Builders' Use of Water		\$
Total			\$ 19.13

33 Labor and Material Report

19

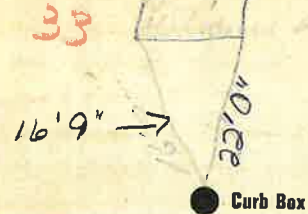

● Curb Box

Main

Elev. of Main at tap

Gate at ●

● Gate at

● Curb Box

H. A. Howard