


Labor and Materials

1	Copper } Connection		\$ 320
1	Lead } Cock Valve		\$ 100
1	Curb } P.S. & V.	in	
1	Service Box } Short 3 1/2 x 4 1/2		\$ 130
	Old returned } Long 4 1/2 x 5 1/2		
		Buff. or Rdway	
11	Ft. } 3/4 in. } Copper	Pipe at	\$ 242
	Nipples	in. at	\$
1	Bushings	3/4 in. to 1/2 in. at	\$ 08
	Red'g } Couplings	to in. at	\$
	Inc'g }		
	Union	in. at	\$
	Meter	in. at	\$
	Lbs. Br. Stone	at	\$
	Lbs. Sand	at	\$
	Bags Cement	at	\$
	Paving Brick } Mack	at	\$
	Lead Joints	at	\$
	Leadite Joints	at	\$
1	Hrs. Foreman	at 620-	\$ 63
1	Hrs. Common Labor	at 50	\$ 50
6	Hrs. Common Labor	at 40 5/8	\$ 244
	Hrs. Mason	at	\$
	Hrs. Mason's Helper	at	\$
	Hrs. Compressor	at	\$
	Compensation Ins.		\$ 10
	Trucking		\$ 100
	Builders' Use of Water		\$

Total \$ 1267

38
Labor and Material Report Aug 30 1916

18 Mahan St

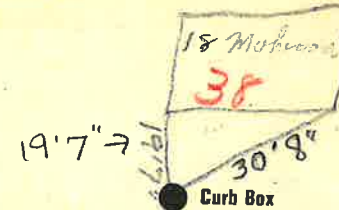

4" Main Elev. of Main at tap 5'

Gate at ● Gate at ●

● Curb Box

Tax ID# 309.36-4-1