

LABOR AND MATERIALS

Copper	} Connection	_____	\$ _____		
Lead		_____	\$ _____		
Curb	} Cock Valve	} _____ in.	\$ _____		
				} T. S. & V.	\$ _____
Service box	} Short 3 1/2 x 4 1/2	} _____	\$ _____		
Old returned				Long 4 1/2 x 5 1/2	
28' 8" Ft.	} Copper	} Pipe at _____	\$ _____		
3/4 in.				<del>C.I.</del>	
Nipples	_____ in. at _____	\$ _____			
Bushings	_____ to _____ in. at _____	\$ _____			
Red'g	} Coupl'gs	} _____ to _____ in. at _____	\$ _____		
Inc'g					
Union	_____ in. at _____	\$ _____			
Meter	_____ in. at _____	\$ _____			
Compound Joints	at _____	\$ _____			
Maintenance Foreman	_____	\$ _____			
Hrs. Water Maint. Man-1	at _____	\$ _____			
Hrs. Water Maint. Man-2	at _____	\$ _____			
Hrs. Garage Foreman	at _____	\$ _____			
Hrs. Labor	at _____	\$ _____			
Hrs. Compressor	at _____	\$ _____			
Trucking	_____	\$ _____			
Pav't Patch	_____	\$ _____			
		\$ _____			
		\$ _____			
SHOULD BE # 37  
 St. \_\_\_\_\_  
 Pl. \_\_\_\_\_  
 Aver. No. (46)


MOHICAN

Name of Owner

EMPIRE AMBULANCE

Labor and Mat'l. Report

19 81

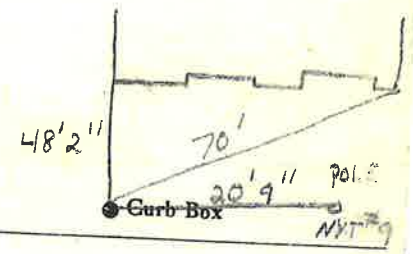

\_\_\_\_\_ Main Elev. of Main at tap \_\_\_\_\_  
 Gate at • Gate at •

• Curb Box