

Labor and Materials


1	Copper } Connection	3	\$ 3.20
	Lead		
1	Curb { Cock Valve T.S. & V. }	3	\$ 1.00
		in.	
1	Service Box { Short 3" x 4" Long 4" x 5" } Old returned { Buff. or Rdway }		\$ 1.20
1.44	Ft. 2 1/2 in. { Copper Galv. Iron Cast Iron } Pipe at		\$ 3.08
1	Nipples	in. at	\$ 1.00
1	Bushings	to in. at	\$.80
	Red'g Inc'g } Couplings	to in. at	\$
	Union	in. at	\$
	Meter	in. at	\$
	Lbs. Br. Stone at		\$
	Lbs. Sand at		\$
	Bags Cement at		\$
	Paving Brick { Mack Red Asphalt }	at	\$
	Lead Joints at		\$
	Leadite Joints at		\$
2	Hrs. Foreman at	6.25	\$ 1.25
7	Hrs. Common Labor at	50	\$ 3.50
10	Hrs. Common Labor at	40.5	\$ 4.05
	Hrs. Mason at		\$
	Hrs. Mason's Helper at		\$
	Hrs. Compressor at		\$
	Compensation Ins.		\$ 24
	Trucking		\$ 1.00
	Builders' Use of Water		\$

Total \$18.81

Labor and Material Report

19

39
RAZED
P

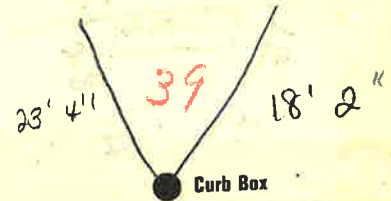

Main

Elev. of Main at top 5'

Gate at ●

● Gate at

● Curb Box

Mark Benjamin

SHUTOFF AT CURB


1-29-1976

39-41 Hospital

Tax ID # 309.36-2-4

Labor and Materials

1	Copper } Connection	3/4	\$ 3.20
	Lead }		
	Curb { Cock		
	Valve }	3/4 in.	\$ 1.00
	T.S. & V. }		
1	Service Box { Short 3 1/2 x 4 1/2		\$ 1.20
	Old returned { Long 4 1/2 x 5 1/2		
	Buff. or Rdway }		
1.4	Pt. 3/4 in. { Copper		\$ 3.08
	Galv. Iron } Pipe at		
	Cast Iron }		
	Nipples	in. at	\$
	Bushings	to in. at	\$.08
	Red'g } Couplings	to in. at	\$
	Inc'g }		
	Union	in. at	\$
	Meter	in. at	\$
	Lbs. Br. Stone at		\$
	Lbs. Sand at		\$
	Bags Cement at		\$
	Paving Brick { Mack		\$
	Red } at		
	Asphalt }		
	Lead Joints at		\$
	Leadite Joints at		\$
2	Hrs. Foreman at	62.10	\$ 1.24
3	Hrs. Common Labor at	5.0	\$ 1.50
21	Hrs. Common Labor at	20.7	\$ 5.53
	Hrs. Mason at		\$
	Hrs. Mason's Helper at		\$
	Hrs. Compressor at		\$
	Compensation Ins.		\$ 2.4
	Trucking		\$ 1.00
	Builders' Use of Water		\$
Total			\$ 21.8

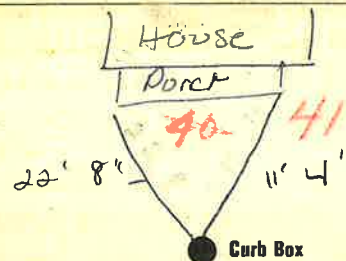

Main Elev. of Main at tap

Gate at ● Gate at ●

● Curb Box

Jacob Goldmann
Shut off at Curb
April-6-1976
39-41 Hospital
Tax ID# 309.36-2-4