

Labor and Materials


1	Copper } Connection	3/4	\$ 3.20
	Lead } in		
1	Curb } Cock	3/4	\$ 1.00
	Valve } in		
	T.S. & V. } in		
1	Service Box } Short 3' x 4'		\$ 1.30
	Old returned } Long 4' x 5'		
	Buff. or Rdway }		
11	Ft. } in. } Copper		\$ 2.42
	Galv. Iron } Pipe at		
	Cast Iron }		
	Nipples	in. at	\$
1	Bushings	3/2 to 1/2 in. at	\$ 1.08
	Red'g } Couplings	to in. at	\$
	Inc'g }		
	Union	in. at	\$
	Meter	in. at	\$
	Lbs. Br. Stone	at	\$
	Lbs. Sand	at	\$
	Bags Cement	at	\$
	Paving Brick } Mack	at	\$
	Red }		
	Asphalt }		
	Lead Joints	at	\$
	Leadite Joints	at	\$
2	Hrs. Foreman	6.25	\$ 1.25
2	Hrs. Common Labor	5.00	\$ 1.00
1.7	Hrs. Common Labor	4.97	\$ 6.91
	Hrs. Mason	at	\$
	Hrs. Mason's Helper	at	\$
	Hrs. Compressor	at	\$
	Compensation Ins.		\$ 2.5
	Trucking		\$ 1.00
	Builders' Use of Water		\$

Total \$ 18.41

26-121 40

Labor and Material Report Aug 31 1926

no 20 inch in st

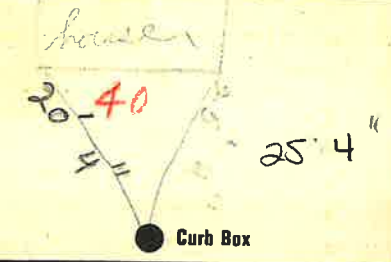

Main Elev. of Main at tap 5'

Gate at ● Gate at ●

● Curb Box

Shut off at Curb
April-23-1926