


Labor and Materials

| | | | |
|----------|---|------------------------|---------|
| 1 | Copper } Connection..... | 3/4 | \$3 20 |
| | Lead } | | |
| 1 | Curb { Cock } | 3/4 in. | \$1 00 |
| | { Valve } | | |
| | { T.S. & V. } | | |
| 1 | Service Box { Short 3 1/2 x 4 1/2 } | | \$1 30 |
| | Old returned { Long 4 1/2 x 5 1/2 } | | |
| | | Buff. or Rdway | |
| 12 | Ft. 3/4 in. { Copper } Pipe at..... | | \$2 56 |
| | | Galv. Iron | |
| | | Cast Iron | |
| | Nipples..... | in. at..... | \$ |
| 1 | Bushings..... | 3/4 to 1/2 in. at..... | \$ 08 |
| | Red'g } Couplings..... | to..... in. at..... | \$ |
| | Inc'g } | | |
| | Union..... | in. at..... | \$ |
| | Meter..... | in. at..... | \$ |
| | Lbs. Br. Stone at..... | | \$ |
| | Lbs. Sand at..... | | \$ |
| | Bags Cement at..... | | \$ |
| | Paving Brick { Mack } at..... | | \$ |
| | { Red } | | |
| | { Asphalt } | | |
| | Lead Joints at..... | | \$ |
| | Leadite Joints at..... | | \$ |
| 2 | Hrs. Foreman at..... | 62.5 | \$ 1 25 |
| 5 | Hrs. Common Labor at..... | 50 | \$ 2 50 |
| 11 | Hrs. Common Labor at..... | 40.7 | \$ 4 47 |
| | Hrs. Mason at..... | | \$ |
| | Hrs. Mason's Helper at..... | | \$ |
| | Hrs. Compressor at..... | | \$ |
| | Compensation Ins..... | | \$ 23 |
| | Trucking..... | | \$ 1 00 |
| | Builders' Use of Water..... | | \$ |
| Total \$ | | | 17 89 |

42
Labor and Material Report Aug 31 1926

no 22 1st St

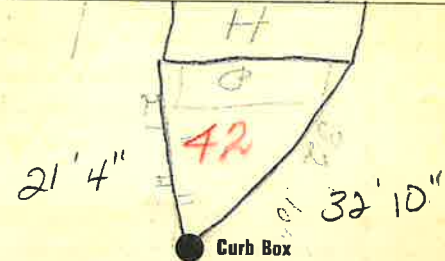

4" Main

Elev. of Main at tap 5

Gate at ●

● Gate at

● Curb Box