


Labor and Materials

1	Copper } Connection	3/4	\$ 3 20
	Lead		
1	Curb { Cock Valve T.S. & V. }	3/4 in.	\$ 1 00
1	Service Box { Short 3 1/2 x 4 1/2 Long 4 1/2 x 5 1/2 } Old returned { Buff. or Rdway }		\$ 1 30
13	Ft. 3/4 in. { Copper Galv. Iron } Pipe at		\$ 2 86
	Nipples	in. at	\$
1	Bushings	3/4 to 1/2 in. at	\$ 0 8
	Red'g Inc'g } Couplings	to in. at	\$
	Union	in. at	\$
	Meter	in. at	\$
	Lbs. Br. Stone at		\$
	Lbs. Sand at		\$
	Bags Cement at		\$
	Paving Brick { Mack Red Asphalt }	at	\$
	Lead Joints at		\$
	Leadite Joints at		\$
1	Hrs. Foreman at	6 3/4	\$ 6 30
2	Hrs. Common Labor at	5 0	\$ 1 00
7	Hrs. Common Labor at	4 0 1/2	\$ 2 84
	Hrs. Mason at		\$
	Hrs. Mason's Helper at		\$
	Hrs. Compressor at		\$
	Compensation Ins.		\$ 1 3
	Trucking		\$ 1 00
	Builders' Use of Water		\$
Total			\$ 14 04

Labor and Material Report

191

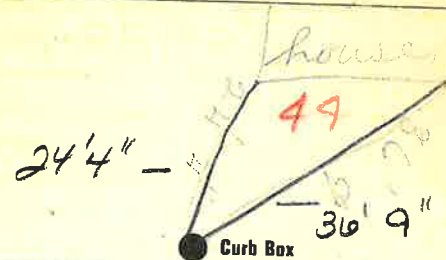

4 Main

Elev. of Main at tap 4'

Gate at ●

● Gate at

● Curb Box

John Deller