


Labor and Materials

1. Copper } Connection.....	$\frac{3}{4}$	\$ 2.60
Lead }	$\frac{3}{4}$	
1. Curb } Cock Valve }	$\frac{3}{4}$	\$ 2.30
} F.S. & V. }		
1. Service Box } Short $3\frac{1}{2} \times 4\frac{1}{2}$ }		\$ 1.40
Old returned } Long $4 \times 4\frac{1}{2}$ }		
} Buff. or Rdway }		
17. Ft. $\frac{3}{4}$ in. } Copper } Pipe at		\$ 4.51
} Galv. Iron }		
} Cast Iron }		
Nipples..... in. at.....		\$
Bushings..... to..... in. at.....		\$
Red'g } Couplings..... to..... in. at.....		\$
Inc'g }		
Union..... in. at.....		\$
Meter..... in. at.....		\$
Lbs. Br. Stone at.....		\$
Lbs. Sand at.....		\$
Bags Cement at.....		\$
Paving Brick } Mack } at.....		\$
} Red }		
} Asphalt }		
Lead Joints at.....		\$
Leadite Joints at.....		\$
11. Hrs. Foreman at.....		\$ 6.88
1. Hrs. Common Labor at.....	@ .50	\$.50
34 Hrs. Common Labor at.....		\$ 13.81
Hrs. Mason at.....		\$
Hrs. Mason's Helper at.....		\$
4 Hrs. Compressor at.....		\$ 6.00
Compensation Ins.....		\$.65
Trucking.....		\$ 1.00
Builders' Use of Water.....	Patch	\$ 5.00
Total		\$ 44.65

28 - *Mohican St*

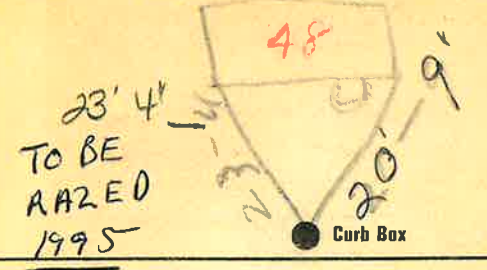

Main Elev of Main at tap 4
 Gate at ● ● Gate at

● Curb Box

old pipe to be dug up

Tax ID# 309.36-3-5