

Mohican Leak 9/19/60

- Curt shut down
8" main + it killed
the leaking plastic
service - can't find
the curb stop for
serv

French Puyon

Ralph Strong

Leak on Mohican

Main

Gate at ●

This service goes to building
add to building in back
Line that go to building
disconnected at Taylor Line
Near building

● Curb Box

St.

Pl.

Ave. No.

Mohican

95


Name of Owner

Taylor Welding Co

Labor and Mat'l. Report

May 16

1961

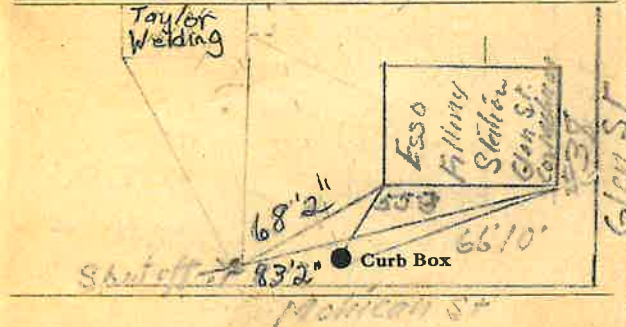

Main

Elev. of

Main at tap

Gate at ●

● Gate at

This service goes to Taylor Welding
add to building in back
Line that go to building
disconnected at Taylor Line
Near building

● Curb Box

