


Labor and Materials

Copper	}	Connection.....	\$
Lead			
Curb	}	Cock	\$
		Valve	
		T. S. & V. } in	
Service Box	}	Short 3½ x 4½	\$
		Long 4½ x 5½	
		Buff. or Rdway	
Old returned			
Ft.in.	}	Copper	\$
		Galv Iron	
		Cast Iron	
Nipples		in. at	\$
Bushings		to	\$
Red'g	}	Conplings.....to	\$
Union		in. at	\$
Meter		in. at	\$
Lead Joints		at	\$
Leadite Joints		at	\$
Hrs. Foreman		at	\$
Hrs. Chauffeur		at	\$
Hrs. Tapper		at	\$
Hrs. Labor		at	\$
Hrs. Labor		at	\$
Hrs. Compressor		at	\$
Compensation Ins.			\$
Trucking			\$
Builders Use of Water			\$
			\$
			\$
St. 57
 Pt. 37
 Ave. No. 37

Name of Owner
Andella

Labor and Mat'l. Report 7-16-17 19

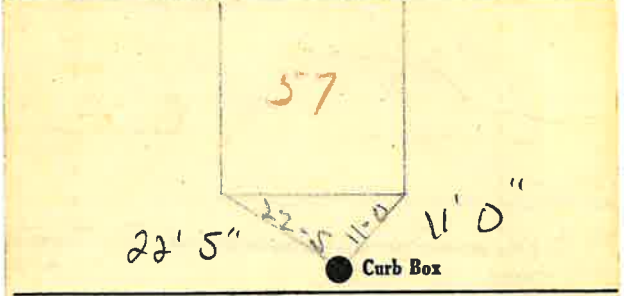

4" Main Elev. of Main at top.....

Gate at ● ● Gate at

● Curb Box