


LABOR AND MATERIALS

1	Copper Lead	Connection	3/4"	\$	308
1	Curb	Cock Valve	3/4 in.	\$	3.89
Same	Service box	T.S. & V.			
	Old returned	Short 3 1/2 x 4 1/2		\$	
		Long 4 1/2 x 5 1/2		\$	
		Buff or Rdway		\$	
20	Ft. 3/4 in.	Copper Pipe at	45	\$	9.00
		G.I.			
		C.I.			
	Nipples	in. at		\$	
	Bushings	to in. at		\$	
	Red'g Inc'g	Coupl'gs to in. at		\$	
	Union	in. at		\$	
	Meter	in. at		\$	
	Lead Joints at			\$	
	Compound Joints at			\$	
4	Maintenance Foreman		1.937	\$	7.75
	Hrs. Water Maint. Man-1 at			\$	
4	Hrs. Water Maint. Man-2 at	1.613		\$	6.45
4	Hrs. Garage Foreman	1.481		\$	5.92
4	Hrs. Labor	at 1.30		\$	5.20
	Hrs. Compressor at			\$	
	Compensation Ins. at \$5.686 per C			\$	2.00
	Trucking			\$	1.50
	Pav't Patch			\$	9.00
	Tap by Gifford			\$	
			4-30-56	\$	
	O'head			\$	
				\$	63.79

St. Mohican
 -Pl- Ave. No. 64

Name of Owner
 Abbott

Labor and Mat'l. Report April 30 1956

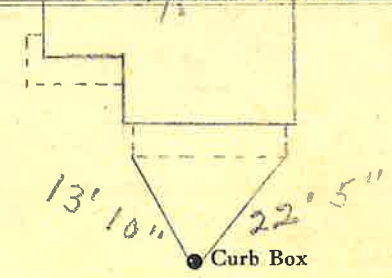

4" Main Elev. of Main at tap 5'
 Gate at • Gate at

• Curb Box

Tax ID# 309.36-3-11