

### LABOR AND MATERIALS

1	Copper Lead	{ Connection	3/4	\$ 1.23	
1	Curb	{ Cock Valve T-S. & V.	3/4 in.	\$ 1.68	
1	Service Box Old returned	{ Short 3 1/2 x 4 1/2 Long 4 1/2 x 5 1/2 Buff. or Rdway		\$ 1.54	
10	Ft. 3/4 in.	{ Copper Galv Iron Cast Iron	Pipe at 17	\$ 1.70	
	Nipples	in. at		\$	
	Bushings	to in. at		\$	
	Red'g Inc'g	{ Couplings	to in. at	\$	
	Union	in. at		\$	
	Meter	in. at		\$	
	Lead Joints	at		\$	
	Leadite Joints	at		\$	
	Hrs. Foreman	at		\$	
2	Hrs. Chauffeur	at	6 3/4	\$ 1.25	
4	Hrs. Tapper	at		\$ 2.50	
4	Hrs. Labor	at	4 1/2	\$ 1.80	
	Hrs. Labor	at		\$	
	Hrs. Compressor	at		\$	
	Compensation Ins.			\$ .18	
	Trucking			\$ 1-	
	Builders Use of Water			\$	
	Taply Hessel			\$	
	Patch (by Sewer Dept)			\$ 2.50	
				\$	
				\$ 15.38	

3 -- 1939

73-75

St.

Pt.

Ave. No.

Mohican

Name of Owner


Adirondack Coal Co.

Yankelowitz

Labor and Mat'l. Report

Nov 6

1939

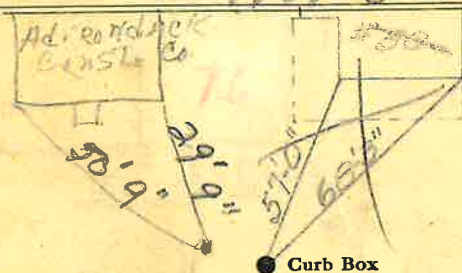

73.79 Tax ID 309.36-2-2

4 Main

Elev. of

Main at tap

4 1/2

Gate at

Gate at

10' to main

● Curb Box

~~This tap measured  
in from #76  
Mohican St.~~

New Tap

TH