

LABOR AND MATERIALS

1	Copper	Connection	\$	
	Lead			
1	Curb	Cock Valve T.S. & V. } $\frac{3}{4}$ in.	\$	
1	Service box	Short $3\frac{1}{2} \times 4\frac{1}{2}$ Long $4\frac{1}{2} \times 5\frac{1}{2}$ Buff or Rdway	\$	
	Old returned			
15 Ft.	$\frac{3}{4}$ in.	Copper G.I. G.I. } Pipe at	\$	
	Nipples	in. at	\$	
	Bushings	to in. at	\$	
	Red'g Inc'g } Coupl'gs	to in. at	\$	
	Union	in. at	\$	
	Meter	in. at	\$	
	Lead Joints at		\$	
	Compound Joints at		\$	
	Maintenance Foreman		\$	
	Hrs. Water Maint. Man-1	at	\$	
	Hrs. Water Maint. Man-2	at	\$	
	Hrs. Garage Foreman	at	\$	
	Hrs. Labor	at	\$	
	Hrs. Compressor at		\$	
	Compensation Ins. at \$	per C	\$	
	Trucking		\$	
	Pav't Patch		\$	
			\$	
			\$	
	O'head		\$	
			\$	

Mohican


St.
Pt.
Ave. No. 103

Name of Owner

W. Gilman

Labor and Mat'l. Report

April 17 1960

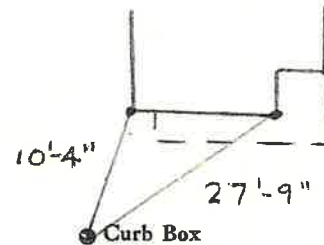

Main

Elev. of
Main at tap

Gate at ●

● Gate at

● Curb Box