

Labor and Materials


Copper	Connection.....	\$.....
Lead		
Curb	{ Cock Valve T.S.&V. }in.....	\$.....
Service Box	{ Short 3 1/2 x 4 1/2 }\$.....	
Old returned	{ Long 4 1/2 x 5 1/2 }\$.....	
	{ Brk. or Raway }	
107 Ft.....in	{ Copper Galv. Iron Cast Iron } Pipe at.....	\$.....
Nipplesin. at.....	\$.....
Bushingsto.....in. at.....	\$.....
Red'g Inc'g	{ Couplings.....to.....in.at.....	\$.....
Unionin. at.....	\$.....
Meterin. at.....	\$.....
Lbs. Br. Stone	at.....	\$.....
Lbs. Sand	at.....	\$.....
Bags Cement	at.....	\$.....
Paving Brick	{ Mack Red Asphalt } at.....	\$.....
Lead Joints	at.....	\$.....
Leadite Joints	at.....	\$.....
Hrs. Foreman	at.....	\$.....
Hrs. Common Labor	at.....	\$.....
Hrs. Common Labor	at.....	\$.....
Hrs. Mason	at.....	\$.....
Hrs. Masons Helper	at.....	\$.....
Hrs. Compressor	at.....	\$.....
Compensation Ins	\$.....
Trucking	\$.....
Builders Use of Water	\$.....
Total \$.....		

11 Labor and Material Report

1932

1-3 Lot Mah... Garage

To BE RAZED 1995

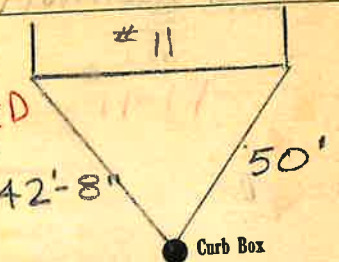

● Curb Box

Elev. of Main at tap 5

Gate at ● Gate at

● Curb Box

Measured 7/4/61

this is 1/2 Mah... St