

LABOR AND MATERIALS


Copper } Connection	_____	\$ _____
Lead } _____	_____	\$ _____
Curb } Cock	_____ in.	\$ _____
T. S. & V. } _____		
Service box } Short 3½ x 4½	_____	\$ _____
Old returned } Long 4½ x 5½		
Buff or Rdway } _____		
? Ft. } in. } Copper } Pipe at	_____	\$ _____
Nipples	_____ in. at _____	\$ _____
Bushings	_____ to _____ in. at _____	\$ _____
Red'g } Coupl'gs	_____ to _____ in. at _____	\$ _____
Inc'g } _____	_____ in. at _____	\$ _____
Union	_____ in. at _____	\$ _____
Meter	_____ in. at _____	\$ _____
Lead Joints	_____ at _____	\$ _____
Compound Joints	_____ at _____	\$ _____
Maintenance Foreman	_____ at _____	\$ _____
Hrs. Water Maint. Man-1	_____ at _____	\$ _____
Hrs. Water Maint. Man-2	_____ at _____	\$ _____
Hrs. Garage Foreman	_____ at _____	\$ _____
Hrs. Labor	_____ at _____	\$ _____
Hrs. Compressor	_____ at _____	\$ _____
Compensation Ins. at \$ _____	_____ per C	\$ _____
Trucking	_____	\$ _____
Pav't Patch	_____	\$ _____
_____	_____	\$ _____
_____	_____	\$ _____
_____	_____	\$ _____
O'head	_____	\$ _____
_____	_____	\$ _____

Measured From
Side of 38 Glen St.

St.
Pl.
Ave. No.

Name of Owner

Labor and Mat'l. Report *Aug. 5, 1963*

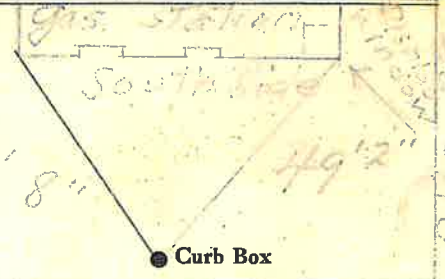

Mobican St.

Main Elev. of Main at tap

Gate at • Gate at •

• Curb Box

*Let Tap
Box Buried at Curb
19"*