


LABOR AND MATERIALS

Copper	}	Connection		\$		
Lead						
Curb	{	Cock Valve	in.		\$	
		T. S. & V.				
Service Box	}	Short 3 1/2 x 4 1/2			\$	
Old returned		Long 4 1/2 x 5 1/2				
		Buff. or Rdway				
Ft.	in.	}	Pipe at		\$	
				Copper		
				Galv Iron		
		Cast Iron				
Nipples	in.	at			\$	
Bushings	to	in.	at		\$	
Red'g	}	Couplings	to	in.	at	
Inc'g						
Union	in.	at			\$	
Meter	in.	at			\$	
Lead Joints	at				\$	
Leadite Joints	at				\$	
Hrs. Foreman	at				\$	
Hrs. Chauffeur	at				\$	
Hrs. Tapper	at				\$	
Hrs. Labor	at				\$	
Hrs. Labor	at				\$	
Hrs. Compressor	at				\$	
Compensation Ins.					\$	
Trucking					\$	
Builders Use of Water					\$	
					\$	
					\$	
St. 12
 Pt. 7
 Ave. No. 7

Name of Owner _____

Labor and Mat'l. Report Aug. 21 1939

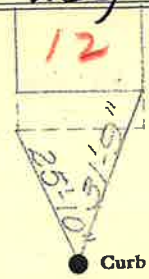

Main Elev. of Main at tap.....

Gate at ● ● Gate at

● Curb Box

Tax ID # 302.16-11-23