

Labor and Material Report

Apr 30 1931

3/4" Tap for Tap at 3 Monrose



Curb Box

6 Main

Elev of Main at tap 5

Gate at ●

● Gate at

● Curb Box


Labor and Material Report

15-20

Apr 30

1931

#3 Main at

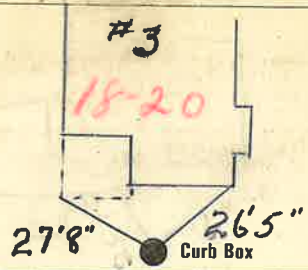

Curb Box

1" Main

Elev of Main at tap 5'

Gate at ●

● Gate at

● Curb Box

Tax ID# 302.16-11-25

Labor and Materials

1	Copper Lead	Connection	3/4"	\$ 2.60
1	Curb	Cock Valve T. S. & V.	3/4" in.	\$ 2.27
	Service Box	Short 3/4x4 1/2		\$
	Old returned	Long 4 1/2x5 1/2	Buff. or Rdway	\$
55	Ft.	1 in.	Copper Galv. Iron Pipe at	\$ 12.10
1	Nipples	in. at	3/4"	\$
1	Bushings	1 1/2" to	3/4" in. at	\$
	Red'g Inc'g	Couplings	to in. at	\$
1	Union	1 1/2" in. at	Plug	\$ .07
	Meter	in. at		\$
	Lbs. Br. Stone	at		\$
	Lbs. Sand	at		\$
	Bags Cement	'at		\$
	Paving Brick	Mack Red Asphalt	'at	\$
	Lead Joints	at		\$
	Leadite Joints	at		\$
8	Hrs. Foreman	at		\$ 5. -
16	Hrs. Common Labor	at	Tapper	\$ 8. -
29	Hrs. Common Labor	at		\$ 12.05
	Hrs. Mason	at		\$
	Hrs. Mason's Helper	at		\$
	Hrs. Compressor	at		\$
	Compensation Ins			\$ .19
	Trucking			\$
	Builders' Use of Water			\$
Total \$				

Labor and Materials

	Copper Lead	Connection		\$
1	Curb	Cock Valve T. S. & V.	3/4" in.	\$ 2.27
1	Service Box	Short 3/4x4 1/2		\$ 1.38
	Old returned	Long 4 1/2x5 1/2	Buff. or Rdway	\$
8	Ft.	3/4 in.	Copper Galv. Iron Pipe at	\$ 1.44
1	Nipples	3/4 in. at	Copper Lead	\$ 1. -
	Bushings	to in. at		\$
	Red'g Inc'g	Couplings	to in. at	\$
	Union	in. at		\$
	Meter	in. at		\$
	Lbs. Br. Stone	at		\$
	Lbs. Sand	at		\$
	Bags Cement	'at		\$
	Paving Brick	Mack Red Asphalt	'at	\$
	Lead Joints	at		\$
	Leadite Joints	at		\$
1	Hrs. Foreman	at		\$ .63
2	Hrs. Common Labor	at	Tapper	\$ 1. -
5	Hrs. Common Labor	at		\$ 2.25
	Hrs. Mason	at		\$
	Hrs. Mason's Helper	at		\$
	Hrs. Compressor	at		\$
	Compensation Ins			\$ .12
	Trucking			\$ 1. -
	Builders' Use of Water	Patch		\$ 5. -
Total \$				16.09