


### Labor and Materials

Lead Connection	.....	\$
Curb Cock	.....	\$
Service Box (Short 3 1/2 x 4 1/2)	.....	\$
Old returned (Long 4 1/2 x 5 1/2 Buffalo)	.....	\$
2.1 Ft. 3/4 in. G. I. Pipe at	.....	\$
Nipples .. in. at ..	.....	\$
Bushings 3/4 to 1 1/2 in. at	.....	\$
Red'g Coup .. to .. in. at	.....	\$
Inc'g Coup .. to .. in. at	.....	\$
Union .. in. at ..	.....	\$
Meter .. in. at ..	.....	\$
Cu. Yds. Br. Stone at ..	.....	\$
Cu. Yds. Sand at ..	.....	\$
Bags Cement at ..	.....	\$
Paving Brick (Mack Red Asphalt) at ..	.....	\$
2/9 Hrs. Foreman at ..	.....	\$
Hrs. Common Labor at ..	.....	\$
Hrs. Mason at ..	.....	\$
Hrs. .... at ..	.....	\$
Hrs. .... at ..	.....	\$
Builders' Use of Water ..	.....	\$
..... at ..	.....	\$
..... at ..	.....	\$
..... at ..	.....	\$
Total	\$ .....	

### Labor and Material Report

1925

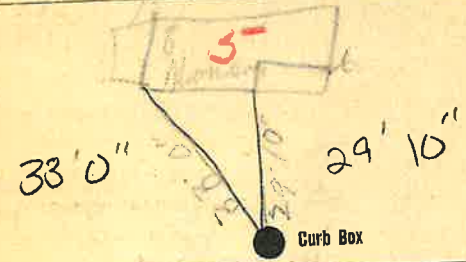

6" Main Elev. of Main at tap 24 1/2  
 Gate at ● Gate at ●

Tax ID # 302.16-10-4