

MONROE


St. Pl. Ave. No. 7

Name of Owner

OUTSIDE CLEAN OUT

Labor and Mat'l. Report

JUNE 2012

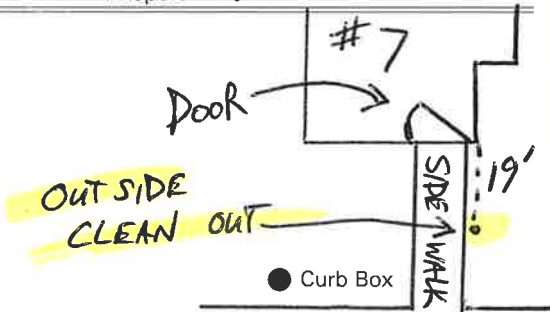

Main

Elev. of Main at tap

Gate at

Gate at

Curb Box

42 1941


St. Pl. Ave. No. 7 6

Name of Owner

White

Labor and Mat'l. Report

June 19 1941

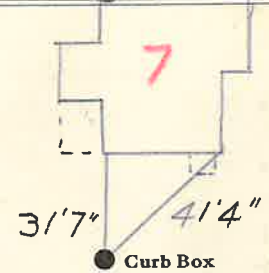

Main

Elev. of Main at tap 5 1/2

Gate at

Gate at

Curb Box

Tax ID # 302.16-10-3

