


Labor and Materials

1 Lead Connection 3/4"\$.
 1 Curb Cock\$.
 Service Box { Short 31 x 41\$.
 Old returned { Long 41 x 51\$.
 Buffalo\$.
 24 Ft. 1" in. G. I. Pipe at\$.
 Nipples..... in. at\$.
 Bushings..... to..... in. at\$.
 Red'g Coup..... to..... in. at\$.
 Inc'g Coup..... to..... in. at\$.
 Union..... in. at\$.
 Meter..... in. at\$.
 Cu. Yds. Br. Stone at\$.
 Cu. Yds. Sand at\$.
 Bags Cement at\$.
 Paving Brick { Mack } at\$.
 Red }
 Asphalt }
 2 Hrs. Foreman at\$.
 7 Hrs. Common Labor at\$.
 Hrs. Mason at\$.
 Hrs. at\$.
 Hrs. at\$.
 Builders' Use of Water *yes*\$.
Bruck\$.
\$.
\$.
 Total \$.....

3/4" tap at 4 Monroe st

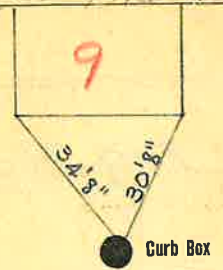

Curb Box

6 Main Elev. of Main at tap *6.4*

Gate at ● Gate at ●

● Curb Box

Tax ID # 302.16-10-2