


LABOR AND MATERIALS

1	Copper	} Connection $\frac{3}{4}$ "	\$
1	Lead		
1	Curb	} Cock Valve F.S. & V. } $\frac{3}{4}$ in.	\$
1	Service box		} Short $3\frac{1}{2}$ x $4\frac{1}{2}$ Long $4\frac{1}{2}$ x $5\frac{1}{2}$ Buff or Rdway }
9	Ft. $\frac{3}{4}$ in.	} Copper G.I. C.I. }	
	Nipples		in. at \$
	Bushings	to in. at \$	
	Red'g Inc'g	} Coupl'gs to in. at \$	
	Union		in. at \$
	Meter	in. at \$	
	Lead Joints at	\$	
	Compound Joints at	\$	
	Maintenance Foreman	\$	
	Hrs. Water Maint. Man-1 at	\$	
	Hrs. Water Maint. Man-2 at	\$	
	Hrs. Garage Foreman at	\$	
	Hrs. Labor at	\$	
	Hrs. Compressor at	\$	
	Compensation Ins. at \$	per C \$	
	Trucking	\$	
	Pav't Patch	\$	
	Tap by G.I. & S. GARDNER CO	\$	
		\$	
		\$	
	O'head	\$	
		\$	

St. Monroe
 Pl. 11
 Ave. No. 11
 Name of Owner Tallon

Labor and Mat'l. Report May 7 1959

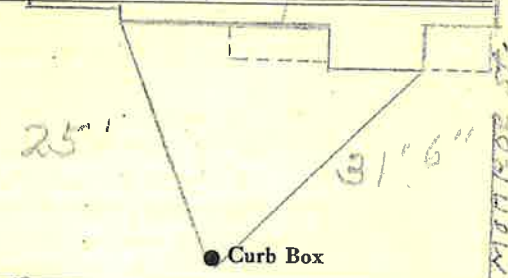

Jefferson St.
 6¹¹ Main Elev. of Main at tap 5'

Gate at • • Gate at

• Curb Box
 Tap on Jefferson
 Tax ID 302.16-10-1 JY
 AXA 16-18 Jefferson