

Labor and Materials

1	Copper	Connection	3/4"	\$ 1.25
1	Lead			
1	Curb	Cock Valve T.S.&V.	3/4" in	\$ 1.70
1	Service Box	Short	3 1/2 x 4 1/2	\$ 1.37
	Old returned	Long	4 1/2 x 5 1/2	
25	Ft.	3/4" in.	Copper Galv. Iron Cast Iron	Pipe at 13/2
	Nipples	in. at		\$ 3.38
	Bushings	to in. at		\$
	Red'g Inc'g	Couplings	to in. at	\$
	Union	in. at		\$
	Meter	in. at		\$
	Lbs. Br. Stone	at		\$
	Lbs. Sand	at		\$
	Bags Cement	at		\$
	Paving Brick	Mack Red Asphalt	at	\$
	Lead Joints	at		\$
	Leadite Joints	at		\$
5 1/2	Hrs.	Foreman	at 62 1/2	\$ 3.44
3 1/2	Hrs.	Common Labor	at 50	\$ 1.75
20 1/2	Hrs.	Common Labor	at 45	\$ 9.23
	Hrs.	Mason	at	\$
	Hrs.	Masons Helper	at	\$
	Hrs.	Compressor	at	\$
	Compensation Ins			\$ 50
	Trucking			\$ 1.00
	Builders Use of Water			\$
Total \$				23.66


1935-121

Labor and Material Report

Aug 10

1935

3/4" tap at 16 Mantecolm 64

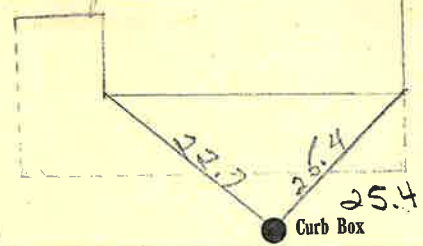

15" Main

Elev. of Main at tap 6

Gate at ●

● Gate at

● Curb Box

~~Equalized off of main~~

To be dug up
to be paid for

[Signature]

Tax ID # 309.27-6-31