

### Labor and Materials

1	Copper	} Connection $\frac{3}{4}$ " in	\$ 1.25	
1	Lead			
1	Curb	} $\frac{3}{4}$ " in	\$ 1.70	
	Cock Valve P.S.&V.			
1	Service Box	} Short $3\frac{1}{2} \times 4\frac{1}{2}$ Long $4\frac{1}{2} \times 5\frac{1}{2}$ Buff. or R3way	\$ 1.37	
	Old returned			
8	Ft. $\frac{3}{4}$ " in	} Copper Galv. Iron Cast Iron	Pipe at (3 1/2) \$ 1.08	
	Nipples		in. at	\$
1	Bushings		$\frac{3}{4}$ " to $\frac{1}{2}$ " in. at	\$ .05
	Red'g Inc'g	} Couplings	to in. at	\$
	Union		in. at	\$
	Meter	in. at	\$	
	Lbs. Br. Stone	at	\$	
	Lbs. Sand	at	\$	
	Bags Cement	at	\$	
	Paving Brick	} Mack Red Asphalt	at	\$
	Lead Joints		at	\$
	Leadite Joints	at	\$	
2	Hrs. Foreman	at $\frac{6.25}{hr}$	\$ 1.25	
1	Hrs. Common Labor	at	\$ .50	
6 1/2	Hrs. Common Labor	at $\frac{45}{hr}$	\$ 2.93	
	Hrs. Mason	at	\$	
	Hrs. Masons Helper	at	\$	
	Hrs. Compressor	at	\$	
	Compensation Ins		\$ 18	
	Trucking		\$ 1.00	
	Builders Use of Water		\$	


Total \$ 11.31

1935-122

Labor and Material Report

1935

*Aug 10*  
*3/4" tap at 17 Monticelo St*

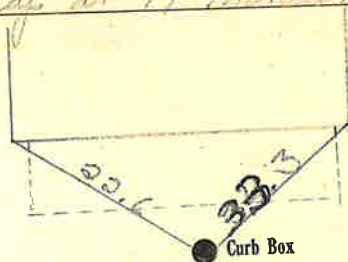

10" Main

Elev. of  
Main at tap *6*

Gate at ●

● Gate at

● Curb Box

*Old tap what off at*

*Main*

Tax ID# 309.27-2-22

*Att*