

Labor and Materials


1	Copper } Connection.....	3	\$ 1.50
1	Lead } Connection.....	3	\$ 1.50
1	Curb { Cock Valve }	3	\$ 1.70
	{ T.S. & V. }	3	
1	Service Box { Short 3 1/2 x 4 1/2 }		\$ 1.54
	Old returned { Long 4 1/2 x 5 1/2 }		
	{ Buff. or Rdw. }		
25	Ft. 3/4 in. { Copper } Pipe at		\$ 4.75
	{ Galv. Iron }		
	{ Cast Iron }		
	Nipples		\$
	Bushings		\$
	Red'g } Couplings..... to..... in. at.....		\$
	Inc'g }		
	Union..... in. at		\$
	Meter..... in. at		\$
	Lbs. Br. Stone at		\$
	Lbs. Sand at		\$
	Bags Cement at		\$
	Paving Brick { Mack } at		\$
	{ Red }		
	{ Asphalt }		
	Lead Joints at		\$
	Leadite Joints at		\$
4	Hrs. Foreman at	6 1/2	\$ 2.50
16	Hrs. Common Labor at	45	\$ 7.20
	Hrs. Common Labor at		\$
	Hrs. Mason at		\$
	Hrs. Masons Helper at		\$
	Hrs. Compressor at		\$
	Compensation Ins		\$ 0.35
	Trucking		\$ 1.-
	Builders Use of Water <i>Paint Patch</i>		\$ 5.-
Total \$			25.54

100 34

Labor and Material Report

Sept 28 19*34*

18 *Mount location dit*

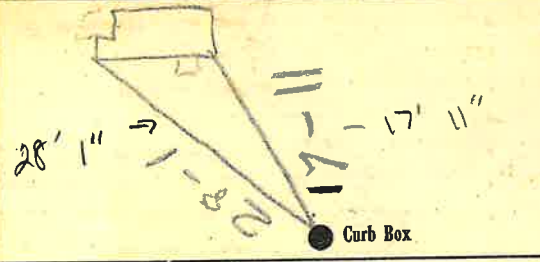

10 Main

Elev. of Main at tap *5 1/2*

Gate at ● Gate at ●

● Curb Box

old tap shut off at main

Tax 10# 309.27-6-32

[Signature]

1/3