

Labor and Materials

1	Copper } Connection ^{3/4"}	\$ 1.25
1	Lead } Connection ^{3/4"}	\$ 1.25
1	Curb { Cock Valve T.S.&V. } ^{3/4} in	\$ 1.70
1	Service Box { Short 3 1/2 x 4 1/2 Long 4 1/2 x 5 1/2 } Old returned { Buff. or Rdway }	\$ 1.37
8	Ft. ^{3/4} in. { Copper Galv. Iron Cast Iron } Pipe at	\$ 1.08
	Nipples in. at	\$
	Bushings to in. at	\$
	Red'g } Couplings to in. at	\$
	Inc'g }	\$
	Union in. at	\$
	Meter in. at	\$
	Lbs. Br. Stone at	\$
	Lbs. Sand at	\$
	Bags Cement at	\$
	Paving Brick { Mack Red Asphalt } at	\$
	Lead Joints at	\$
	Leadite Joints at	\$
7	Hrs. Foreman at ^{6 2/2}	\$ 1.25
1	Hrs. Common Labor at ⁵⁰	\$.50
6 1/2	Hrs. Common Labor at ⁴⁵	\$ 2.93
	Hrs. Mason at	\$
	Hrs. Masons Helper at	\$
	Hrs. Compressor at	\$
	Compensation Ins	\$.18
	Trucking	\$ 1.00
	Builders Use of Water	\$
Total		\$ 11.26


1935-123

Labor and Material Report

Aug 10

1935

3/4" top at 19 Main at tap

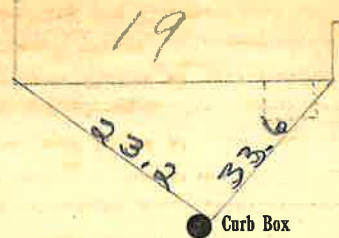

10" Main

Elev. of Main at tap 6

Gate at ●

● Gate at

● Curb Box

to be dug up.
digging old to keep edge for
old dug up + shut off

THH

Tax ID # 309.27-2-21