


**Labor and Materials**

1	Copper	Connection	1.50
1	Lead		
1	Curb	Cock Valve	1.70
1	Service Box	Short 3 1/2 x 4 1/2	1.44
	Old returned	Long 4 1/2 x 5 1/2	
		Butt on Power	
27	Ft.	3/4 in. Copper Galv. Iron Cast Iron	Pipe at 5.13
	Nipples	in. at	\$
	Bushings	to in. at	\$
	Red'g Inc'g	Couplings to in. at	\$
	Union	in. at	\$
	Meter	in. at	\$
	Lbs. Br. Stone	at	\$
	Lbs. Sand	at	\$
	Bags Cement	at	\$
	Paving Brick	Mack Red Asphalt at	\$
	Lead Joints	at	\$
	Leadite Joints	at	\$
9	Hrs. Foreman	at 62 1/2	5.63
25	Hrs. Common Labor	at 45	11.25
	Hrs. Common Labor	at	\$
	Hrs. Mason	at	\$
	Hrs. Masons Helper	at	\$
	Hrs. Compressor	at	\$
	Compensation Ins		2.61
	Trucking		3
	Builders Use of Water	Part Patch	5
Total			35.26

4 Mount Colver St

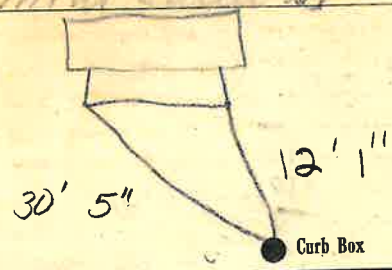

10 Main Elev. of Main at tap 52

Gate at ● Gate at ●

● Curb Box

old Tap to Dog up

*[Handwritten signature]*

Tax ID# 309.27-6-25

*[Handwritten mark]*