

**Labor and Materials.**


1... Copper } Connection. 3/4".....	\$ 1.25
1... Lead } .....	
1... Curb { Cock Valve } 3/4" in .....	\$ 1.70
1... T.S.&V. } .....	
1... Service Box { Short 3 1/2 x 4 1/2 } .....	\$ 1.37
Old returned { Long 4 1/2 x 5 1/2 } .....	
Buff. or Rdway } .....	
24 Ft. 3/4" in. { Copper } Pipe at 13 1/2 x \$ 3.24	
{ Galv. Iron } .....	
{ Cast Iron } .....	
..... Nipples ..... in. at .....	\$ .....
..... Bushings ..... to ..... in. at .....	\$ .....
Red'g } Couplings..... to ..... in. at .....	\$ .....
Inc'g } .....	
..... Union..... in. at .....	\$ .....
..... Meter..... in. at .....	\$ .....
..... Lbs. Br. Stone at .....	\$ .....
..... Lbs. Sand at .....	\$ .....
..... Bags Cement at .....	\$ .....
..... Paving Brick { Mack } at .....	\$ .....
..... Red } .....	
..... Asphalt } .....	
..... Lead Joints at .....	\$ .....
..... Leadite Joints at .....	\$ .....
5 1/2 Hrs. Foreman at .....	\$ 3.44
2 1/2 Hrs. Common Labor at .....	\$ 1.75
20 1/2 Hrs. Common Labor at .....	\$ 9.73
..... Hrs. Mason at .....	\$ .....
..... Hrs. Masons Helper at .....	\$ .....
..... Hrs. Compressor at .....	\$ .....
..... Compensation Ins .....	\$ .54
..... Trucking .....	\$ 1.-
..... Builders Use of Water .....	\$ .....
Total \$ 23.52	

1935-124

Labor and Material Report

19

3/4" tap at 22 Mantoloking St.

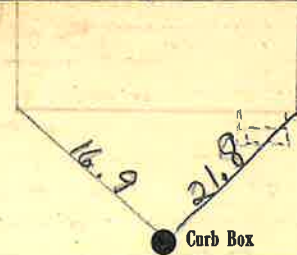

10" Main

Elev. of Main at tap 6

Gate at ●

● Gate at

● Curb Box

old tap shut off at main

Tax ID # 309.27-6-34

*ASB*