

Labor and Materials

1...Copper } Connection. 3/4"	\$ 1.75
1...Lead }	
1...Curb { Cock Valve T.S.&V. } 3/4 in	\$ 1.70
1...Service Box { Short 3 1/2 x 4 1/2 Long 4 1/2 x 5 1/2 } Old returned { Buff. or Rdrway }	\$ 1.37
10...Ft. 3/4 in. { Copper Galv. Iron Cast Iron } Pipe at 12 1/2	\$ 1.35
.....Nipples in. at	\$
1...Bushings 3/4 to 1/2 in. at	\$.25
.....Red'g } Couplings.....to.....in.at	\$
.....Inc'g }	
.....Union.....in. at	\$
.....Meter.....in. at	\$
.....Lbs. Br. Stone at	\$
.....Lbs. Sand at	\$
.....Bags Cement at	\$
.....Paving Brick { Mack Red Asphalt } at	\$
.....Lead Joints at	\$
.....Leadite Joints at	\$
7...Hrs. Foreman at 6 1/2 hr.	\$ 1.75
1...Hrs. Common Labor at	\$.50
6 1/2...Hrs. Common Labor at 45	\$ 2.93
.....Hrs. Mason at	\$
.....Hrs. Masons Helper at	\$
.....Hrs. Compressor at	\$
.....Compensation Ins	\$.18
.....Trucking	\$ 1.-
.....Builders Use of Water	\$
Total \$ 11.58	


1935-125

Labor and Material Report

Aug 10

1936

3/4" tap of 23 Montcalm St.

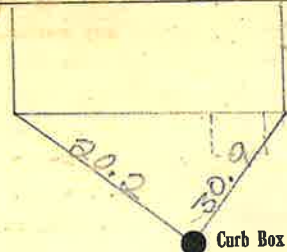

10" Main

Elev. of Main at tap 6

Gate at ●

● Gate at

● Curb Box

old tap shut off at main

Tax ID# 309.27-2-20

[Handwritten signature]